GENERAL ARRANGEMENT

M/T NORTH CONTENDER

SCALE 1:200

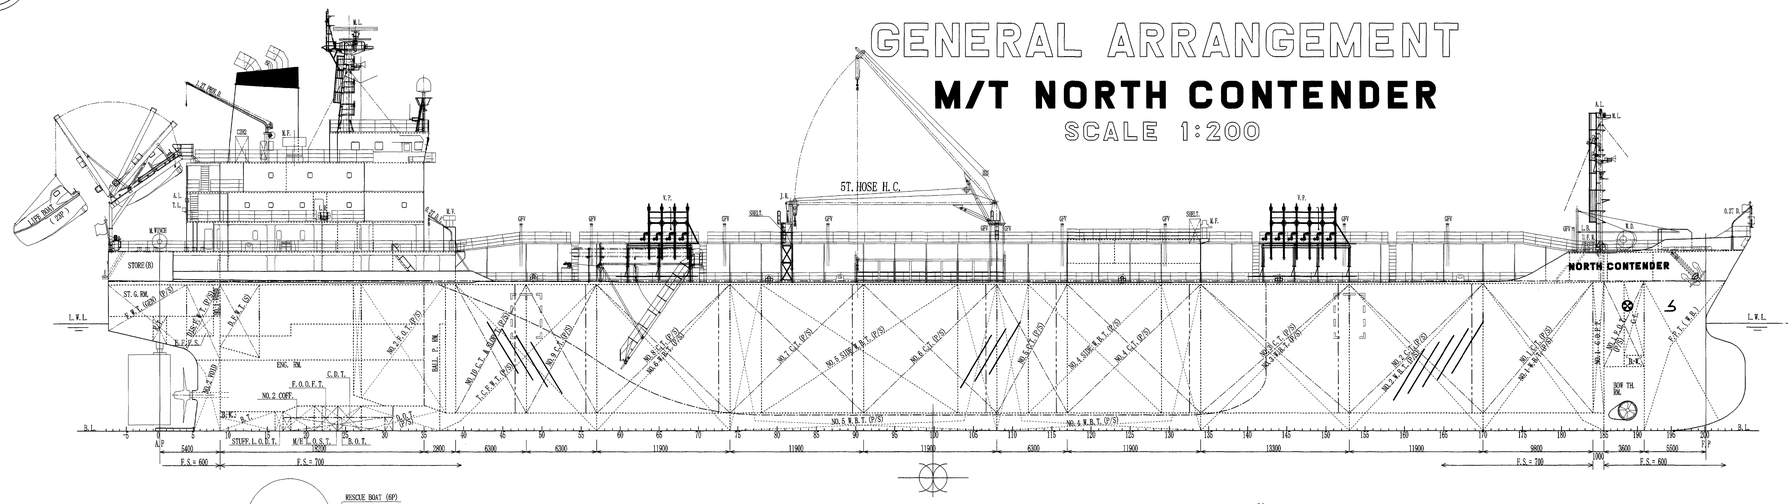

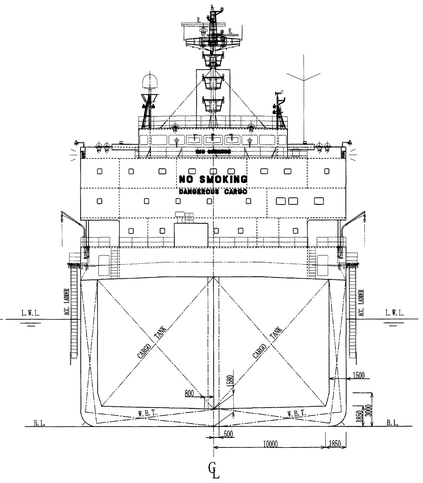

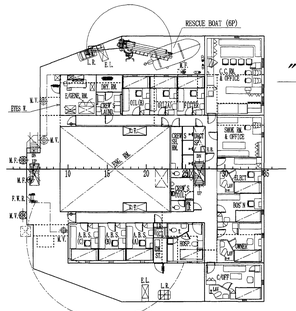

"B" DECK

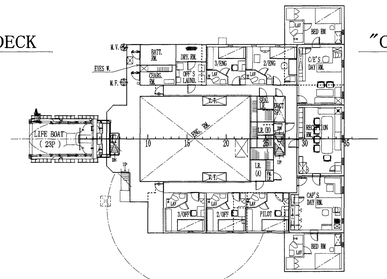

"C" DECK

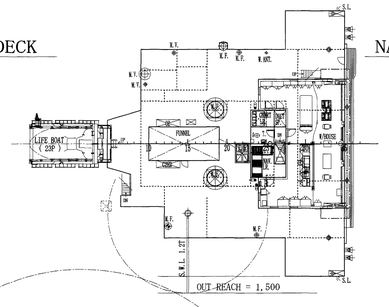

NAV. BRI. DK.

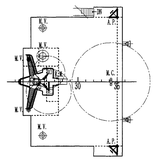

COMP. DK.

"A" DECK

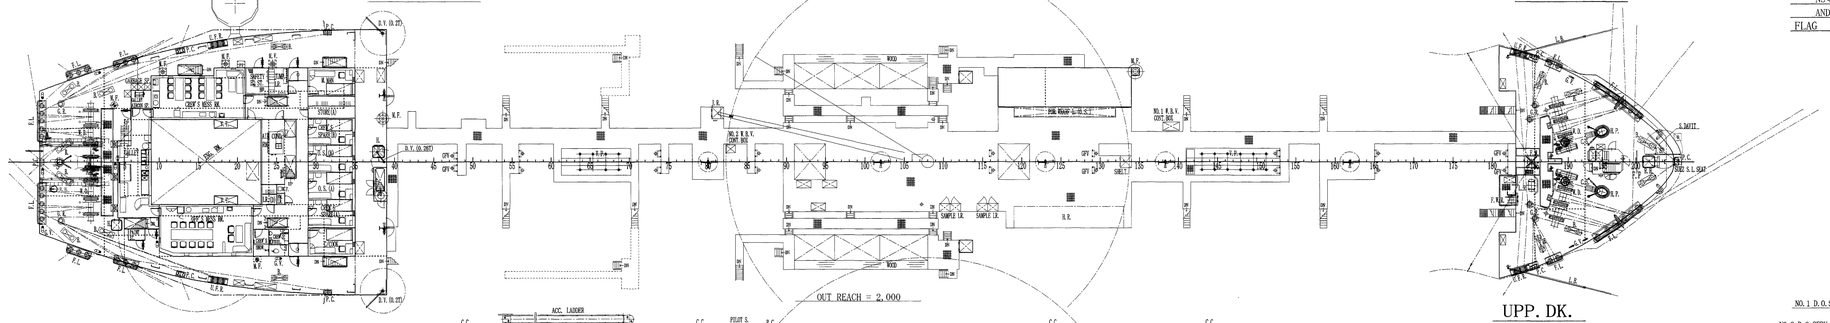

F'CLE DK.

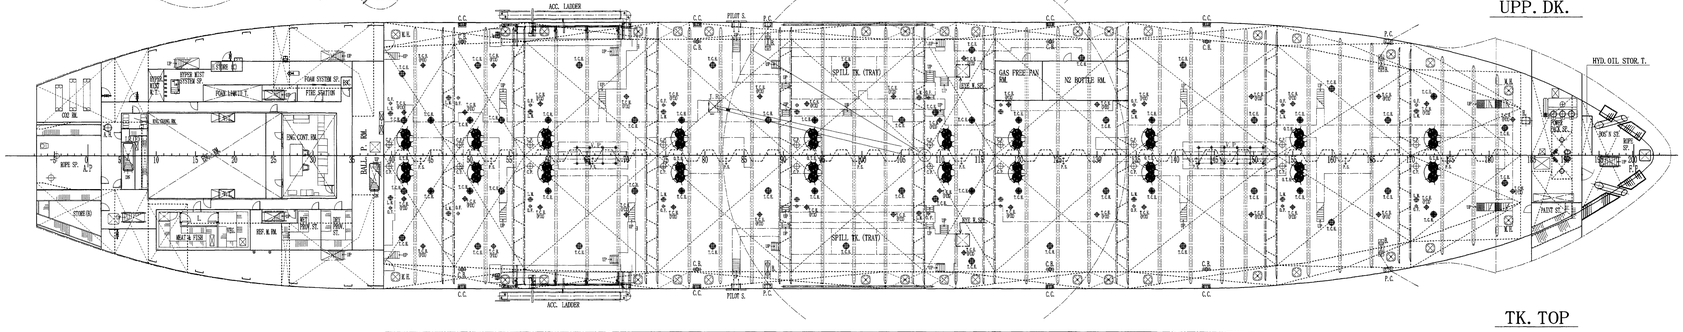

UPP. DK.

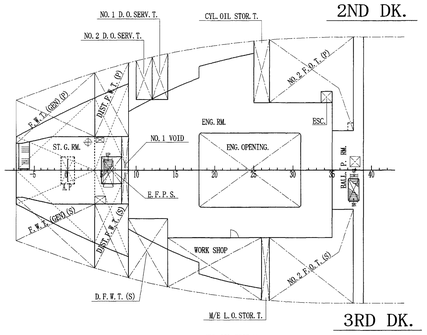

2ND DK.

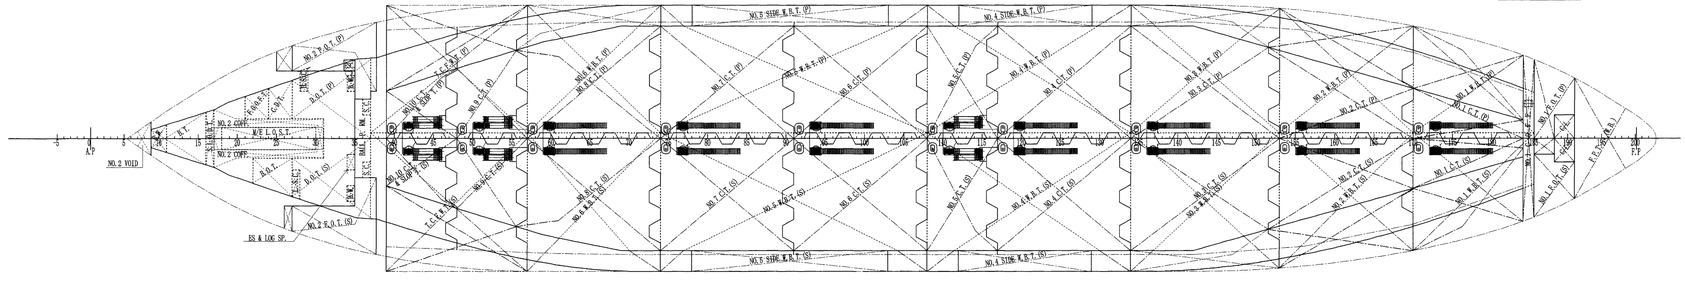

TK. TOP

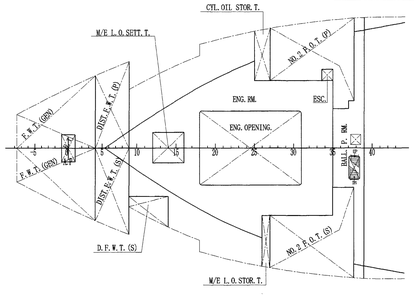

3RD DK.

PRINCIPAL PARTICULARS

LENGTH	(O. A.)	146.60	M
LENGTH	(B. P.)	138.00	M
BREADTH	(M型)	23.70	M
DEPTH	(M型)	13.00	M
DRAFT	(SUMMER EXTREME)	9.616	M
DEAD WEIGHT		19,925.47	MT
GROSS TONNAGE		11,662	
MAIN ENGINE	B&W 6S42MC(Mark 6)		
	6,150 kW (8,370 PS) × 136 r/m-1	1	SET
SPEED(TRIAL MAX.)		15.423	KNOTS
SERVICE SPEED		14.6	KNOTS
COMPLEMENT		23	P
CLASS	NIPPON KAIJI KYOKAI		
	NS* (TANKER, OILS-FLASHPOINT ON AND BELOW 60℃		
	AND CHEMICALS TYPE II&III) (ESP)MNS*		
FLAG		PANAMA	

BIBLIOGRAPHY

OCT. 17th 2005 完成図として作製す。
To be prepared for finished plan.

NORTH CONTENDER

NHo. F-1256

D.W. 19,700 MT TYPE
CHEMICAL TANKER

GENERAL
ARRANGEMENT

FINISHED PLAN

SCALE 1/200

DESIGNING DEPARTMENT
OF
FUKUOKA SHIPBUILDING CO. ,LTD
FUKUOKA
JAPAN

MANAGER	
ASSISTANT M	
CHIEF OF SEC'N	
CHECKED BY	Y. Kobashima
DRAWN BY	K. Tanamoto
DRAWN DATE	OCT. 17th 2005
ISSUED DATE	
DRAWING NO.	GH-1000

配布先
配 主
I G
N A
監 督
定 業
設 材
倉 庫
工 場 民
N C
船 台
炭 殻
内 業
地 上
塗 装
甲 板
甲 管
電 装
機 装
機 管
甲 外
機 外
技 倉
工 務
瓦 政
設 政
ボ 政
機 政
電 政
設
計

815×1125